



**NORTH RILDA CANYON
PORTAL FACILITIES**

U-06039

SL-051221

AS-BUILT FACILITIES DISTURBED AREA = 6.77 ACRES

END EMERY COUNTY ROAD 306

Helco Mine
(1940-50's)

Leroy/Comfort Mine
(1940-50's)


EMERGENCY
SEDIMENTATION POND

U-06039

SL-050862

5' HEAVY TIMBER
RE-SEED AS SPECIFIED
SPREAD TOPSOIL &
RE-SEED AS SPECIFIED

5' HEAVY TIMBER
RE-SEED AS SPECIFIED
SPREAD TOPSOIL &
RE-SEED AS SPECIFIED

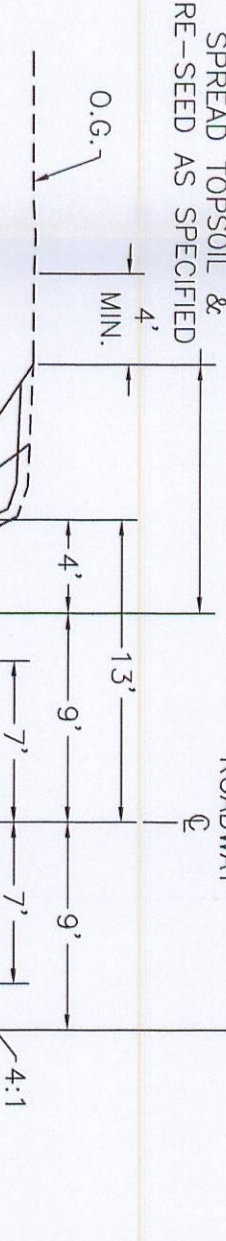

TYPICAL ROAD SECTION

NOTES:

RESTRICTED USE AREA STARTS APPROXIMATELY 1/4 MILE WEST OF THE CATTLE GUARD AND EXTENDS APPROXIMATELY 2300 FEET TO THE MINE GATE IN THE LEFT FORK OF RILDA CANYON

REFER TO JOHANSEN & TUTTLE ENGINEERING, INC.
ROAD DESIGN RILDA CANYON ROAD IMPROVEMENT PROJECT
CHANGE ORDER NO. 1
VOLUME 11 APPENDIX VOLUME-ENGINEERING: APPENDIX G



File no: **R645-301-5008**
Date: **06/01/2008**
Scale: **1"=100'**
Sheet: **1 of 1**



DATE	REVISION	BY	CHK	DATE	SHEET	REV.
2/10/2010	ADDED AS-BUILT DISTURBED AREA BOUNDARY, REVISED TOPSOIL FENCE & ADDED MINE GATES				1	1